

PROJECT

MAI KAI RESTAURANT
EXTERIOR UPGRADES

3599 N FEDERAL HWY
OAKLAND PARK
FLORIDA

CD-22-17Z

CD DEVELOPMENT REVISIONS

No.	DATE	DESCRIPTION
A		
B		
C		

PERMIT REVISIONS

No.	DATE	DESCRIPTION
1		
2	10/28/22	DRC REVIEW COMMENTS
3	12/16/22	DRC REVIEW COMMENTS
4		


CONSTRUCTION PHASE REVISIONS

No.	DATE	DESCRIPTION
AA		
BB		
CC		


PROJECT PHASE

- ☐ SITE PLANNING
☒ SCHEMATIC DESIGN
☐ DESIGN DEVELOPMENT
☐ CONSTRUCTION DOCUMENTS

PROJECT NUMBER: JBC.25
ISSUED: 05/19/2022
DRAWN BY: SNB
CHECKED BY: MAB
FILENAME: JBC25SDP.dwg

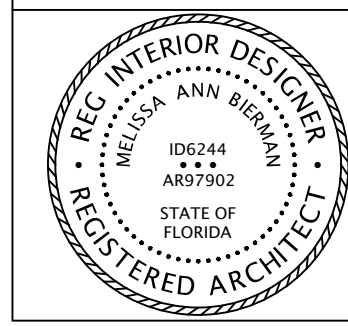

SHEET
SP-8

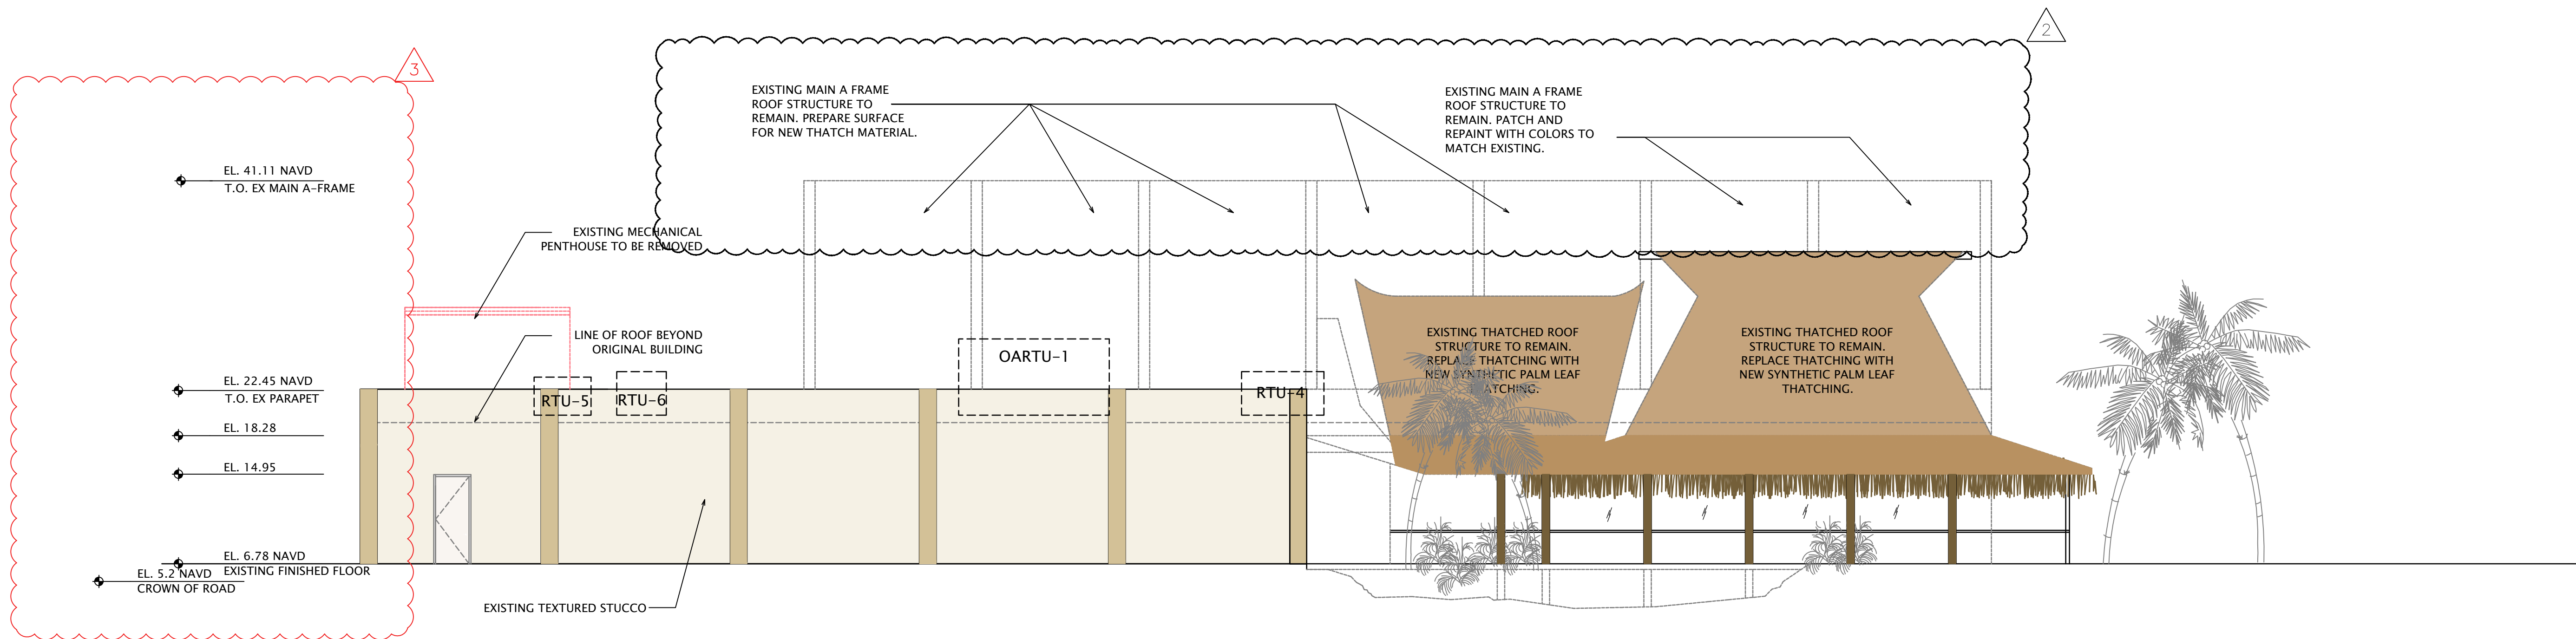


01 EXISTING EXTERIOR ELEVATION- SOUTH

1/8" = 1'-0"



INSPIRATION IMAGES OF PROPOSED FINISH MATERIAL

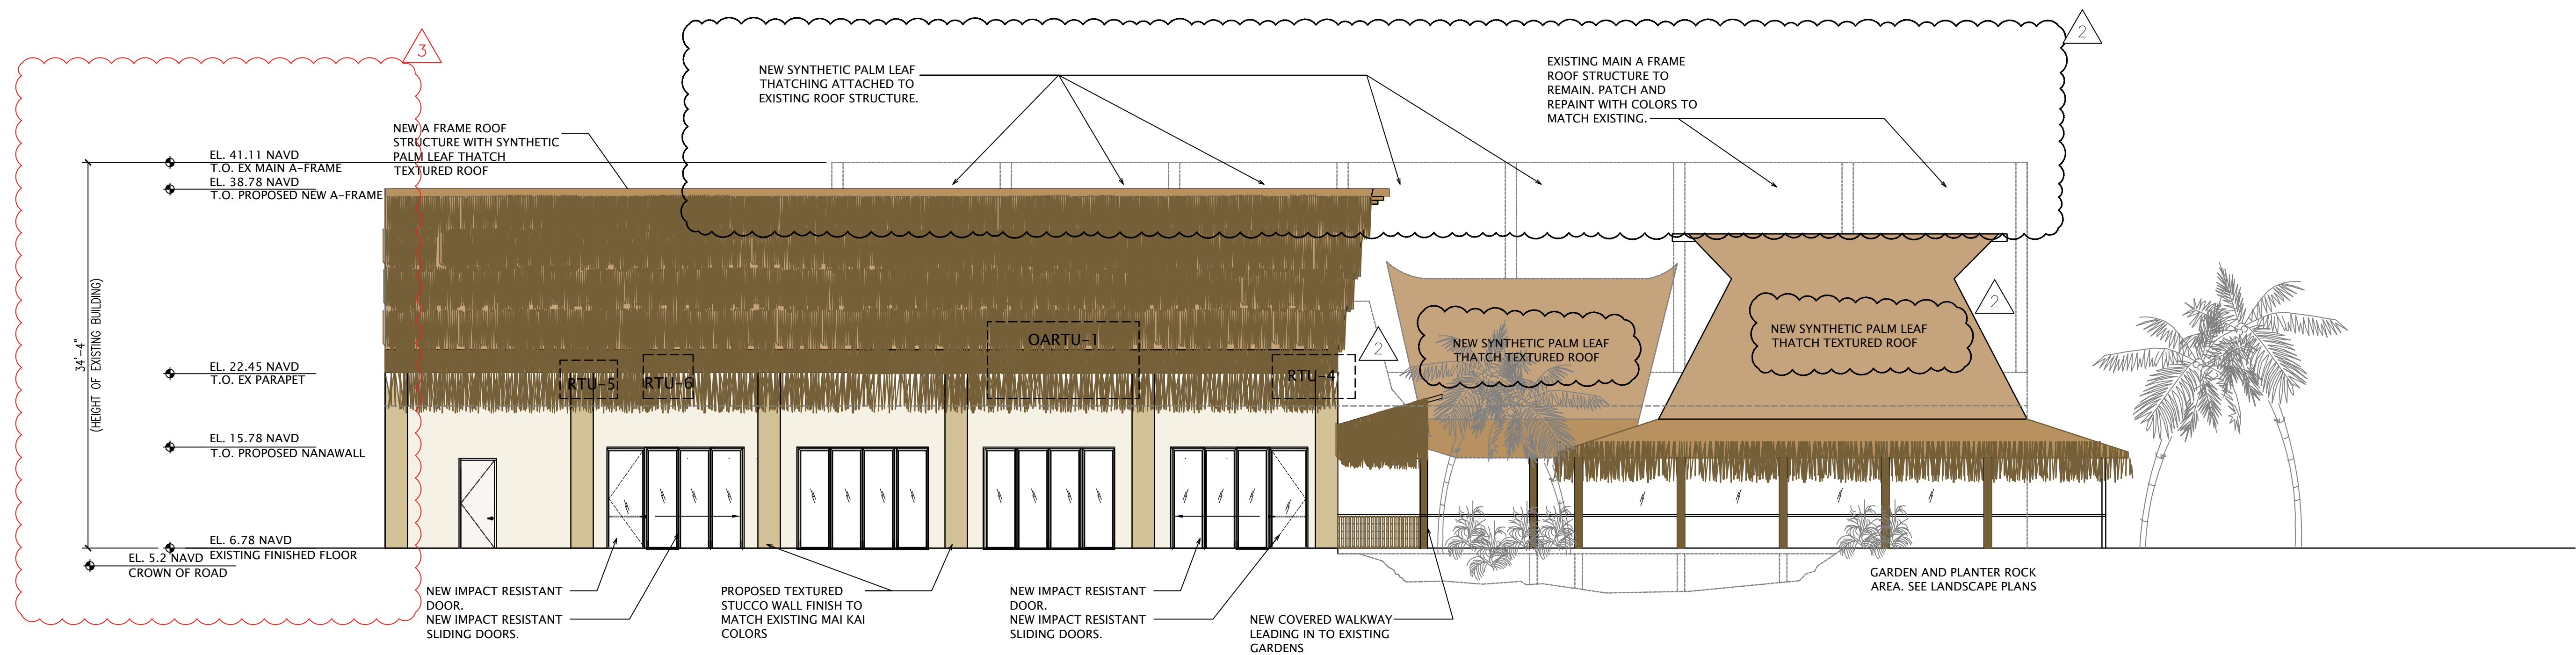

02 PROPOSED EXTERIOR ELEVATION- SOUTH

1/8" = 1'-0"

PROJECT

MAI KAI RESTAURANT
EXTERIOR UPGRADES

3599 N FEDERAL HWY
OAKLAND PARK
FLORIDA

CD-22-17Z

CD DEVELOPMENT REVISIONS

No.	DATE	DESCRIPTION
A		
B		
C		

PERMIT REVISIONS

No.	DATE	DESCRIPTION
1		
2	10/28/22	DRC REVIEW COMMENTS
3	12/16/22	DRC REVIEW COMMENTS
4		


CONSTRUCTION PHASE REVISIONS

No.	DATE	DESCRIPTION
AA		
BB		
CC		

PROJECT PHASE


- ☐ SITE PLANNING
☒ SCHEMATIC DESIGN
☐ DESIGN DEVELOPMENT
☐ CONSTRUCTION DOCUMENTS

PROJECT NUMBER: JBC.25
ISSUED: 05/19/2022
DRAWN BY: SNB
CHECKED BY: MAB
FILENAME: JBC25SDP.dwg

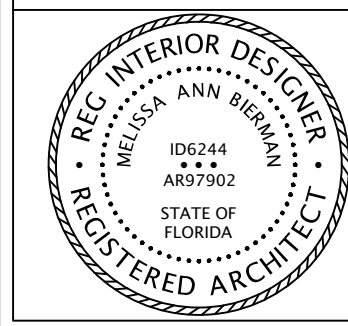


SHEET

SP-9

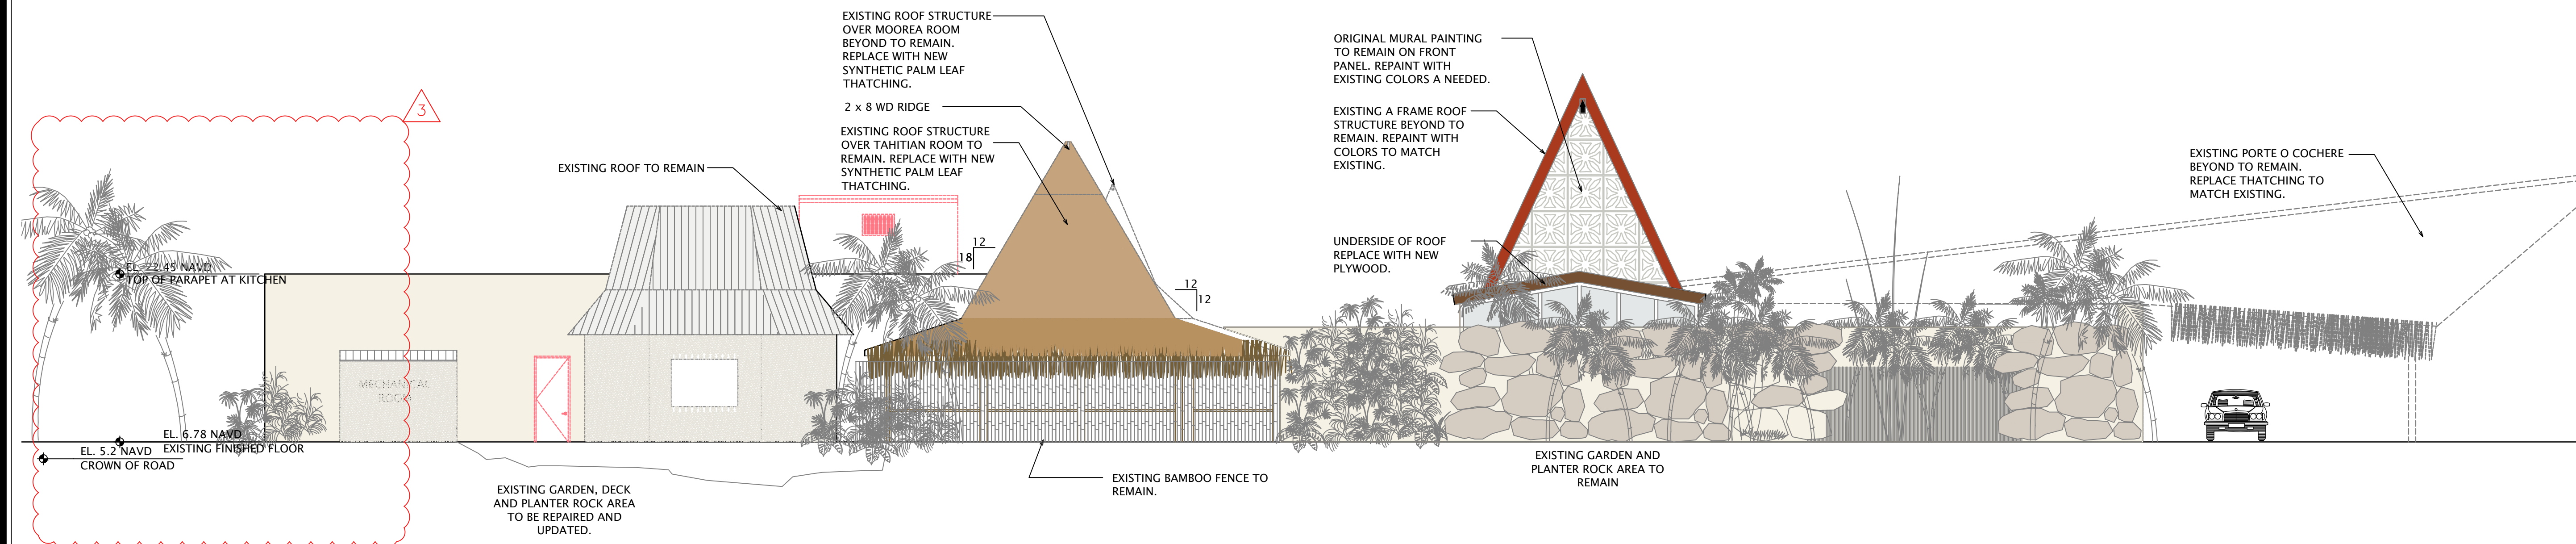

01 EXISTING EXTERIOR ELEVATION-EAST

1/8" = 1'-0"

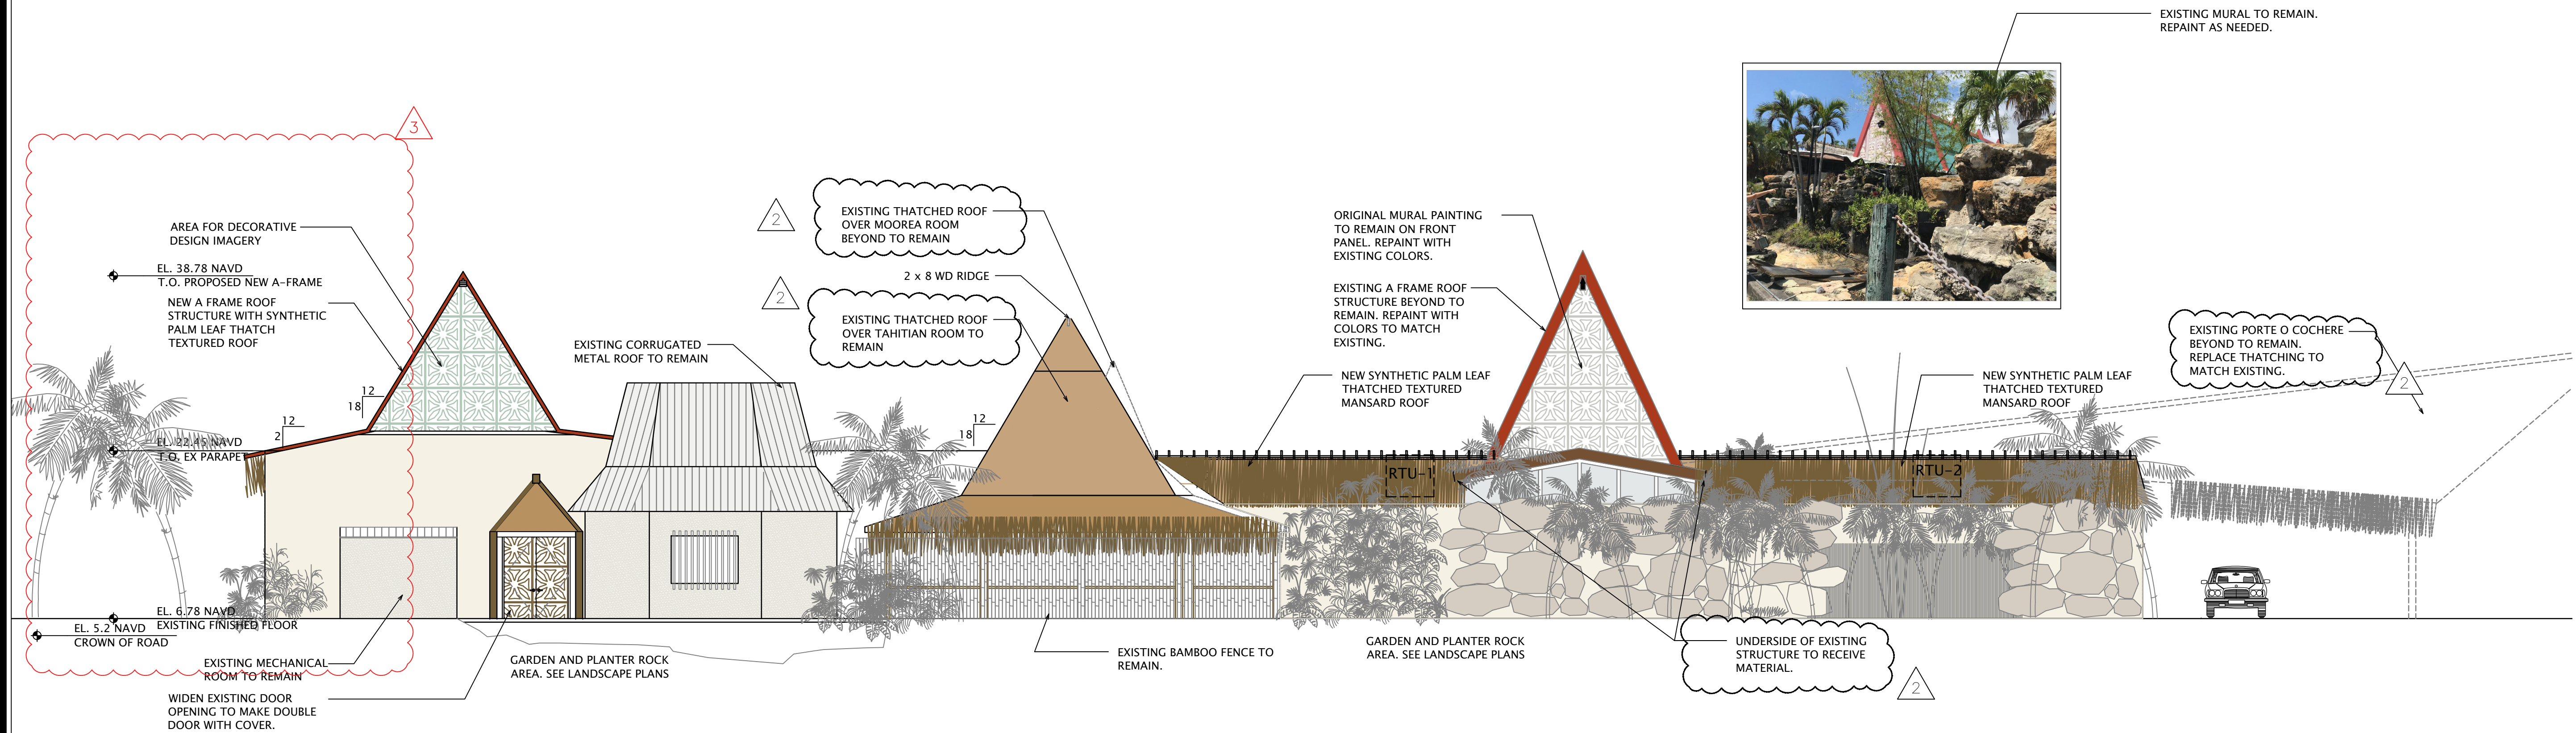

02 PROPOSED EXTERIOR ELEVATION-EAST

1/8" = 1'-0"

PROJECT

MAI KAI RESTAURANT
EXTERIOR UPGRADES

3599 N FEDERAL HWY
OAKLAND PARK
FLORIDA

CD-22-17Z

CD DEVELOPMENT REVISIONS

No.	DATE	DESCRIPTION
A		
B		
C		

PERMIT REVISIONS

No.	DATE	DESCRIPTION
1		
2	10/28/22	DRC REVIEW COMMENTS
3	12/16/22	DRC REVIEW COMMENTS
4		


CONSTRUCTION PHASE REVISIONS

No.	DATE	DESCRIPTION
AA		
BB		
CC		


PROJECT PHASE

- ☐ SITE PLANNING
☒ SCHEMATIC DESIGN
☐ DESIGN DEVELOPMENT
☐ CONSTRUCTION DOCUMENTS

PROJECT NUMBER: JBC.25
ISSUED: 05/19/2022
DRAWN BY: SNB
CHECKED BY: MAB
FILENAME: JBC25SDP.dwg


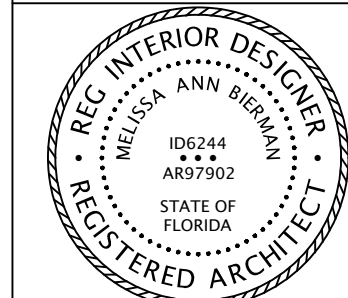


SHEET
SP-10

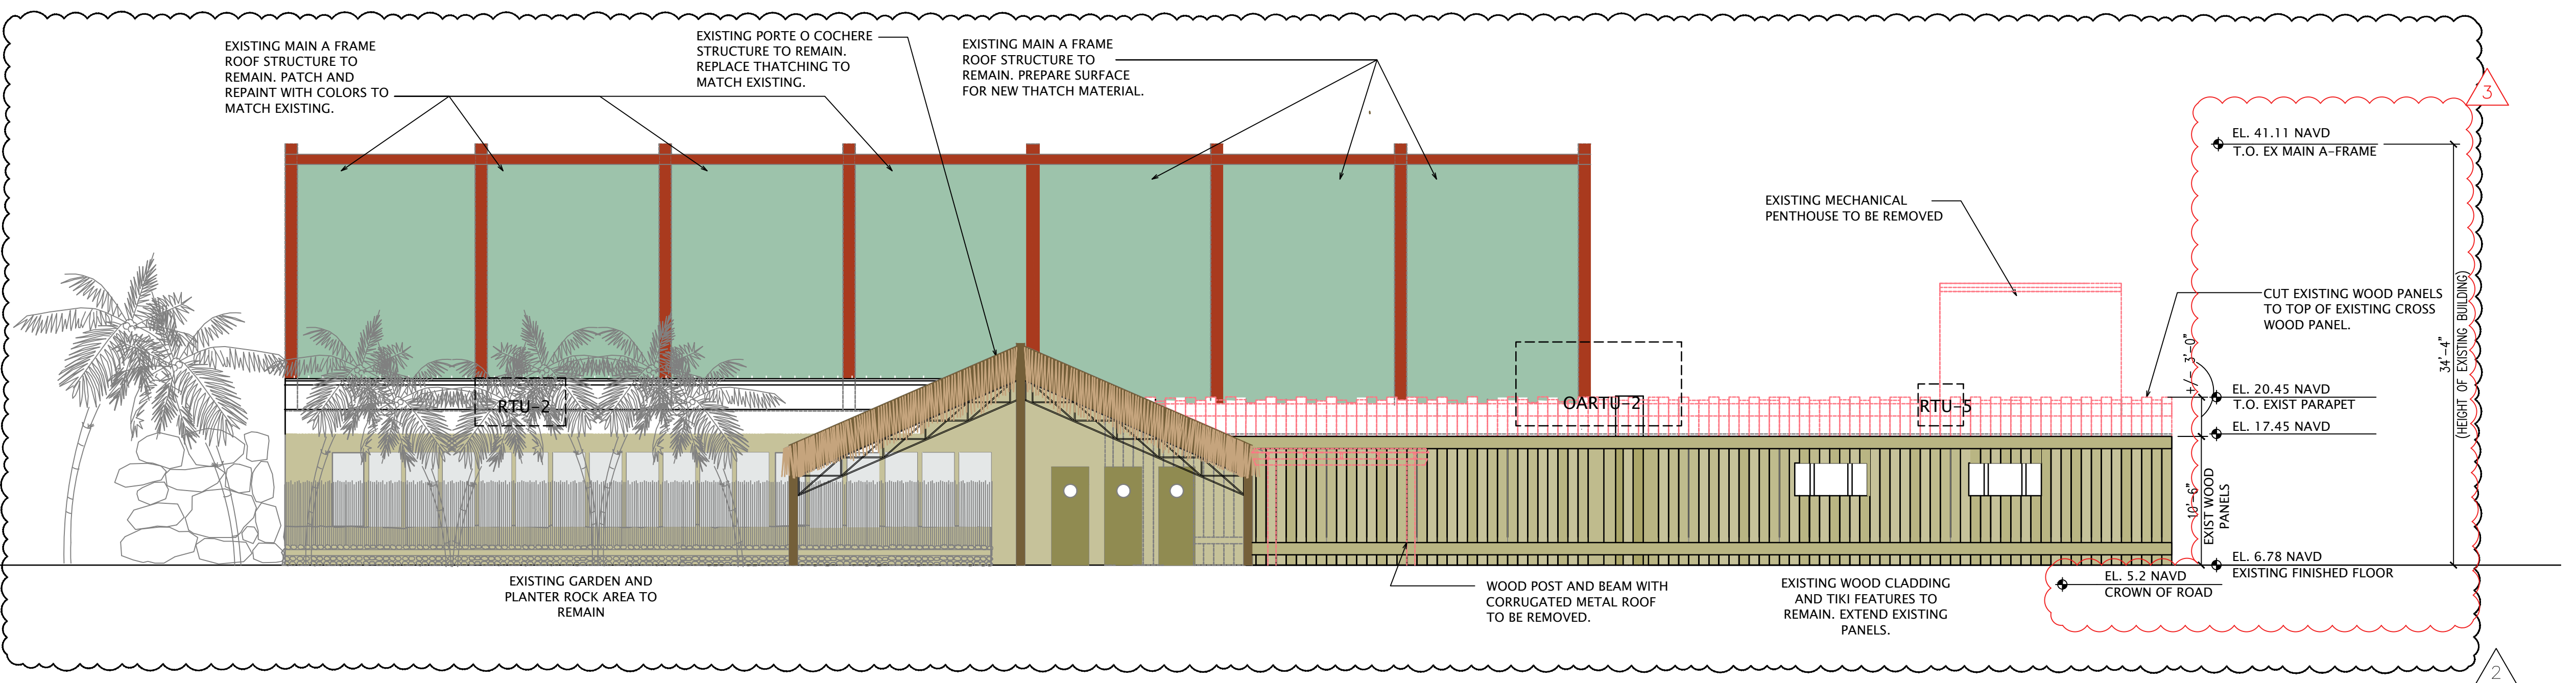

01 EXISTING EXTERIOR ELEVATION- NORTH

1/8" = 1'-0"

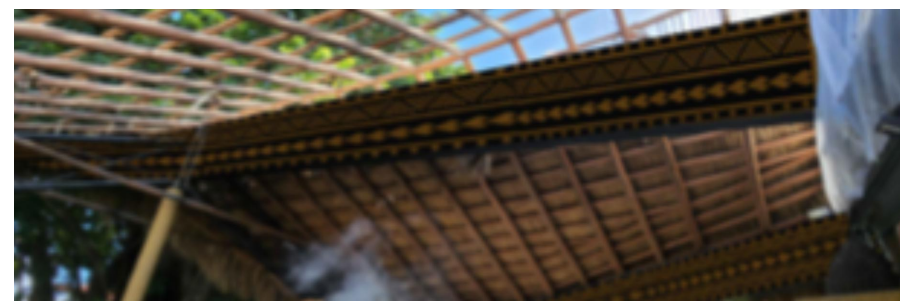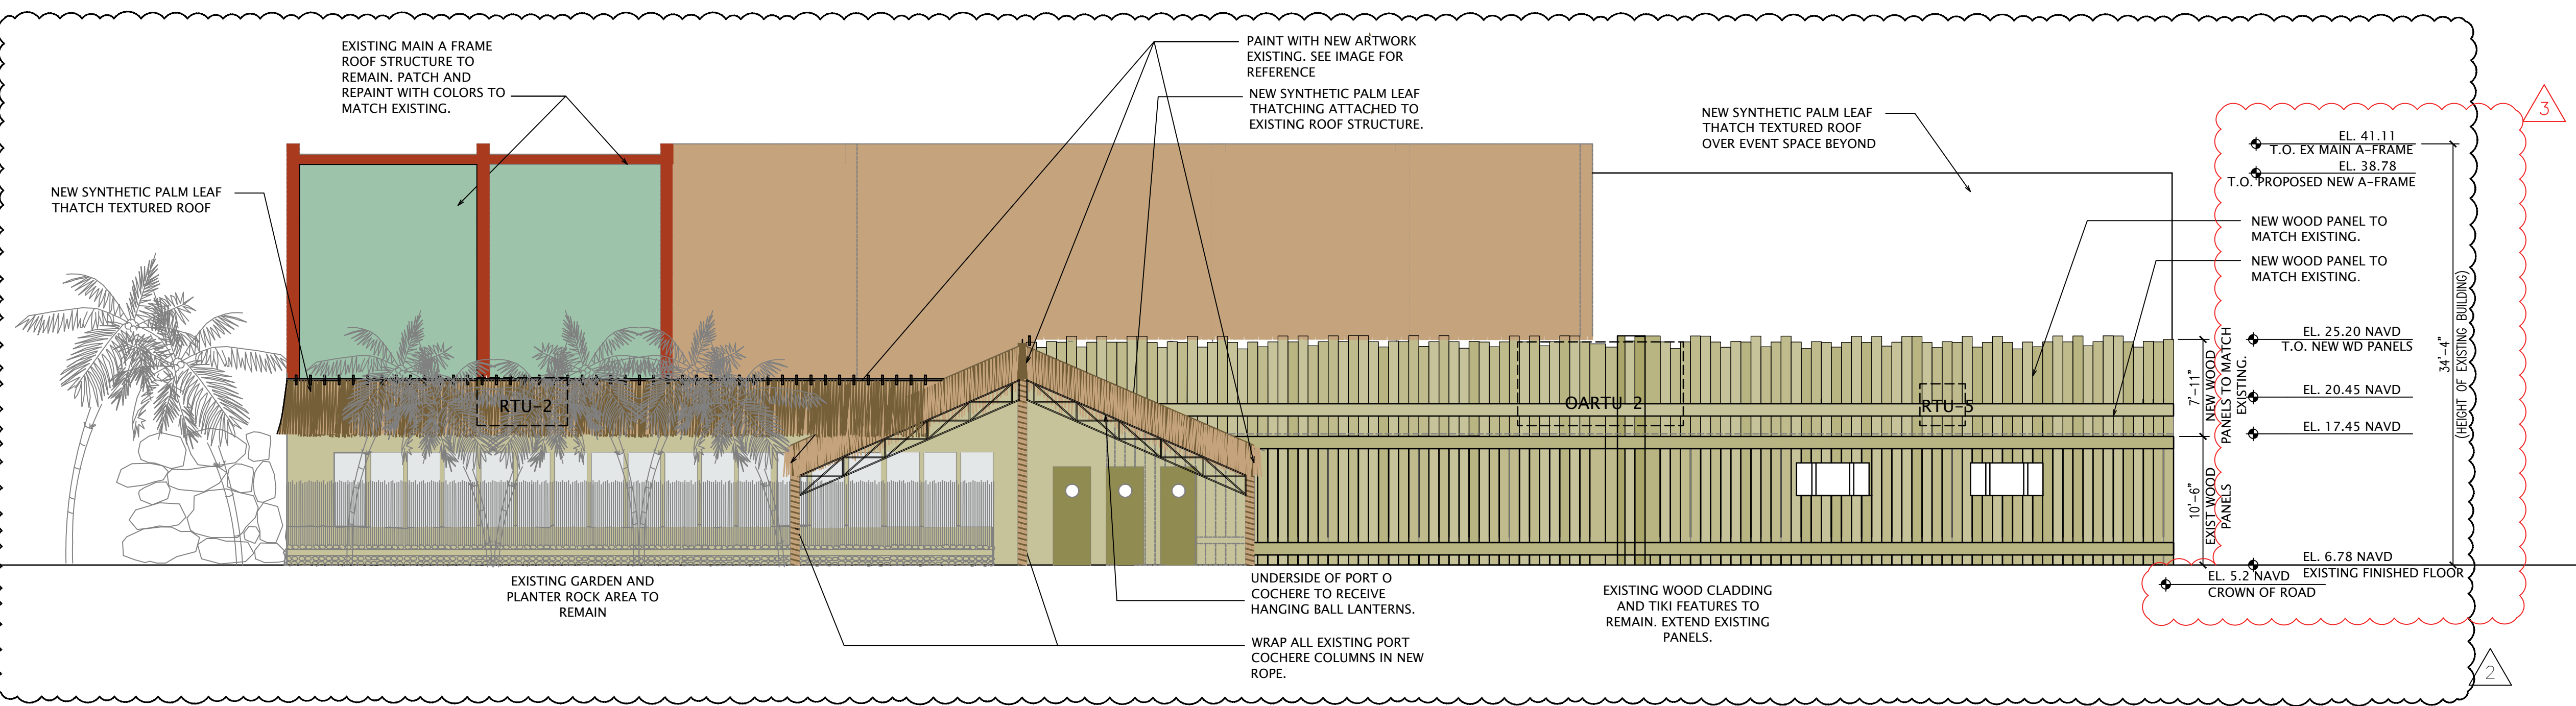

02 PROPOSED EXTERIOR ELEVATION- NORTH

1/8" = 1'-0"

PROJECT

MAI KAI RESTAURANT
EXTERIOR UPGRADES

3599 N FEDERAL HWY
OAKLAND PARK
FLORIDA

CD-22-17Z

CD DEVELOPMENT REVISIONS

No.	DATE	DESCRIPTION
A		
B		
C		

PERMIT REVISIONS

No.	DATE	DESCRIPTION
1		
2	10/28/22	DRC REVIEW COMMENTS
3	12/16/22	DRC REVIEW COMMENTS
4		


CONSTRUCTION PHASE REVISIONS

No.	DATE	DESCRIPTION
AA		
BB		
CC		

PROJECT PHASE


- ☐ SITE PLANNING
☒ SCHEMATIC DESIGN
☐ DESIGN DEVELOPMENT
☐ CONSTRUCTION DOCUMENTS

PROJECT NUMBER: JBC.25
ISSUED: 05/19/2022
DRAWN BY: SNB
CHECKED BY: MAB
FILENAME: JBC25SDP.dwg

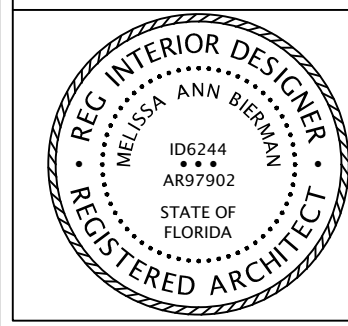


SHEET

SP-11

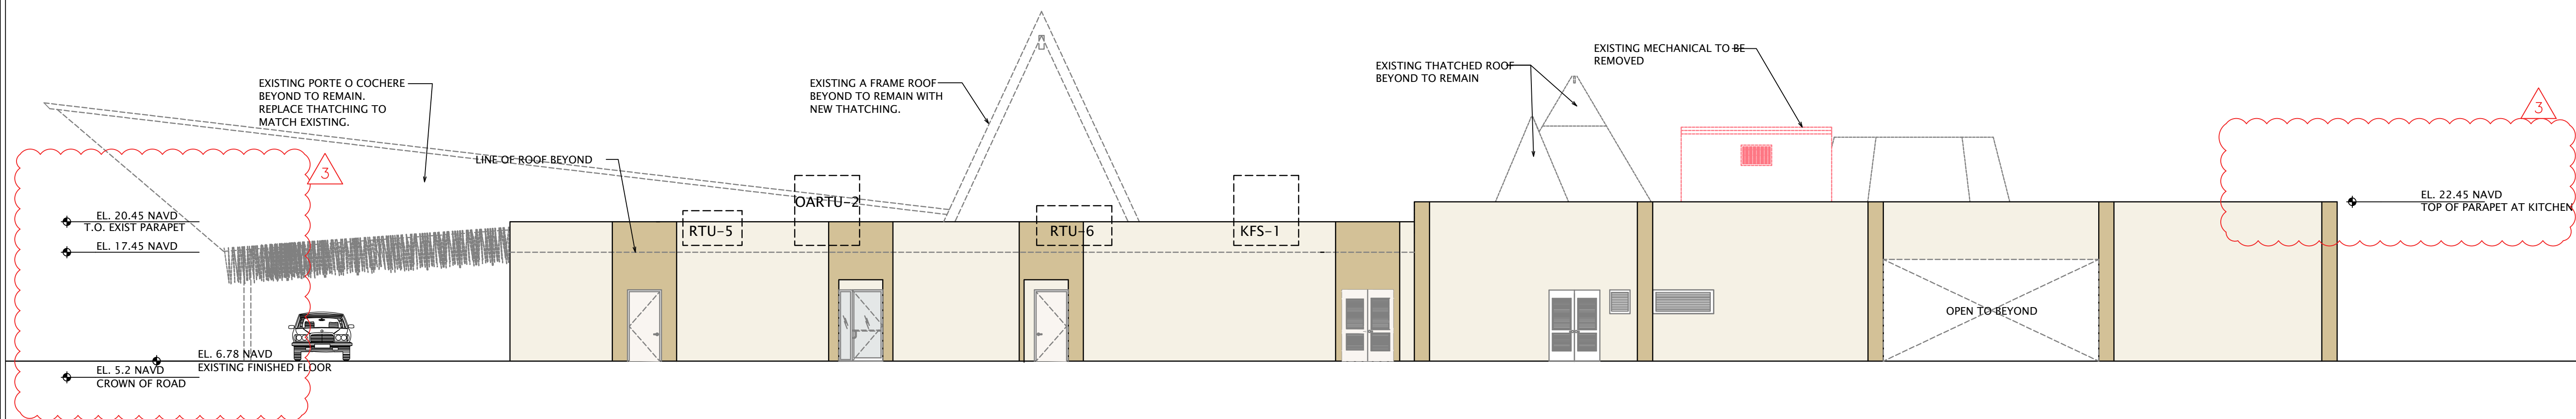

01 EXISTING EXTERIOR ELEVATION- WEST

1/8" = 1'-0"

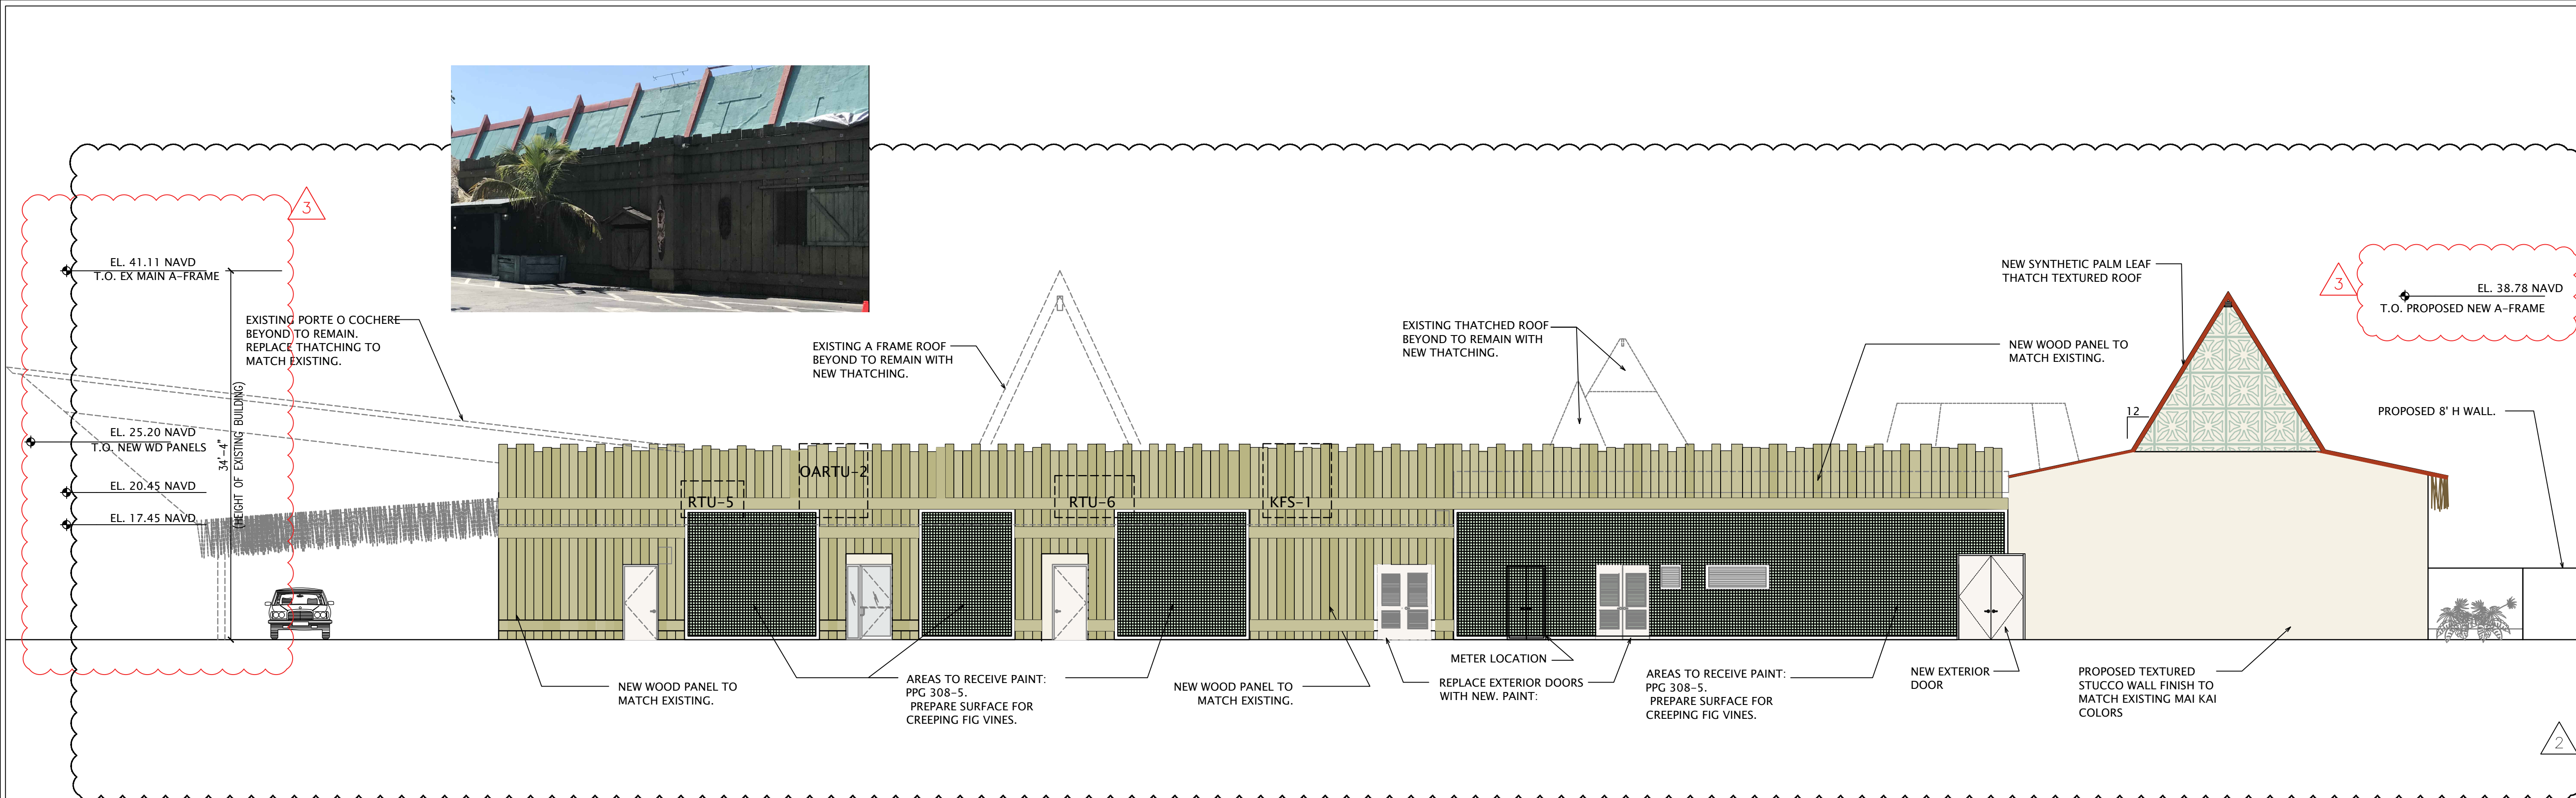

02 PROPOSED EXTERIOR ELEVATION- WEST

1/8" = 1'-0"